

IMPROVEMENT LOCATION CERTIFICATE

IN ACCORDANCE WITH C.R.S. 38-51-108 (EFFECTIVE JULY 1, 2013)

THIS CERTIFICATE IS VALID ONLY FOR USE BY:

**STONE CONCEPTS OF COLORADO INC. AND
BRYAN BELLOWS AND MARA MACTAGGART**

**CHAMBERS AVENUE
80' PUBLIC RIGHT-OF-WAY**

R=640.00
L=178.68'
Δ=15°59'47"
T=89.93
CH=N53°08'47"E
178.10

CONCRETE SIDEWALK

FOUND SURVEY MONUMENT
1.5" ALUMINUM CAP ON
REBAR STAMPED LS 20695
PEDESTALS

FOUND SURVEY MONUMENT
1.5" ALUMINUM CAP
ON REBAR ILLEGIBLE

10' DRAINAGE AND UTILITY EASEMENT

25' BUILDING SETBACK

SEWER
CLEANOUT

1 1/4"
IRON
PIPE

12.5' DRAINAGE AND UTILITY EASEMENT

12.5' BUILDING SETBACK

140.00'

LOT C-31

**LOT C-30
0.62 ACRES**

1248

VACANT LOT

Proposed area for raw material storage
Red-line boundaries indicate location of fencing

25' BUILDING SETBACK

25' DRAINAGE AND UTILITY EASEMENT

FOUND SURVEY MONUMENT
1.5" ALUMINUM CAP ON
REBAR STAMPED LS 20695

FOUND SURVEY MONUMENT
1.5" ALUMINUM CAP
ON REBAR ILLEGIBLE

UTIL.
POLE

WOOD PRIVACY
FENCE

S53°20'51"W

222.39'

OVERHEAD UTILITY LINE

LOT I-12

Archibeque Land Consulting, Ltd

~ Professional Land Surveying & Mapping ~

115 Broadway - P.O. Box 3893

Eagle, Colorado 81631

970.328.6020 Office 970.328.6021 Fax

INFO@PROLANDSURVEY.COM



1 INCH = 10 FEET

DESCRIPTION

Lot C-30, Eagle Valley Commercial Park, Filing No. 2, Town of Eagle, Colorado, according to the Final Plat thereof as filed for record October 18, 1996 as Reception No. 604859, in the Office of the Clerk and Recorder, county of Eagle, State of Colorado.

NOTES:

1) Survey Date: February 10, 2017.

2) Location of Improvements, Lot lines, Building Setbacks and Easements are based upon the hereon referenced Final Plat of Eagle Valley Commercial Park, Filing No. 2 and Survey Control Monuments found, as shown hereon.

3) Street Address: 1248 Chambers Ave., per the Eagle County C.I.S. (Not Posted)

4) This Improvement Location Certificate was prepared for the exclusive use of Stone Concepts, and is valid only if print has original seal and signature of surveyor.

5) Lineal Units of the U.S. Survey Foot were used herein.

C.R.S. 38-51-108 (Effective July 1, 2013)

IMPROVEMENT LOCATION CERTIFICATE

I hereby certify that this Improvement Location Certificate was prepared for
Stone Concepts of Colorado Inc. and Bryan Bellows and Mara Mactaggart

that this is NOT a Land Survey Plat, or Improvement Survey Plat, and that it is not to be relied upon for the establishment of fence, building, or other future improvement lines.


THIS CERTIFICATE IS VALID ONLY FOR USE BY

Stone Concepts of Colorado Inc. and Bryan Bellows and Mara Mactaggart

AND DESCRIBES THE PARCEL'S APPEARANCE ON

February 10, 2017

I further certify that the improvements on the above described parcel on this date, **February 10, 2017**, except for utility connections, are entirely within the boundaries of the parcel, except as shown, that there are no encroachments upon the described premises by improvements on any adjoining premises, except as indicated, and there is no apparent evidence or sign of any easement crossing or burdening any part of said parcel, except as shown.

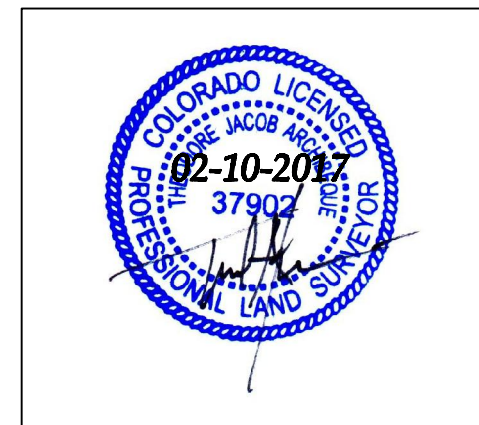

Theodore J. Archibeque PLS 37902
Colorado Professional Land Surveyor

IMPROVEMENT LOCATION CERTIFICATE LOT C-30 EAGLE VALLEY COMMERCIAL PARK FILING 2 TOWN OF EAGLE, COUNTY OF EAGLE, STATE OF COLORADO

DRAWN BY: KMD	JOB NUMBER: 14114	DRAWING NAME: 14114_ILC.dwg
SHEET 1 OF 1	DATE: 03-26-2014	CHECKED BY: TJA

© Copyright 2014 by ARCHIBEQUE LAND CONSULTING, Ltd. All rights reserved, including all trademarks & copyrights and all other intellectual property rights in the contents hereof & all land survey, certificates and/or related documents created, drafted, checked or stamped by this firm. The certificates, maps, plats, surveys, exhibits and any other contents herein are not to be copied, reproduced, printed, published, posted, displayed, incorporated, stored in or scanned into a retrieval system or database, transmitted, broadcasted, bartered or sold, in whole or in part, without the prior express written permission of the sole author, who is, unless otherwise directed, Theodore J. Archibeque. Unauthorized duplication, transfer to another party, or future use by any individual or firm who is, or is not certified to herein is strictly prohibited and is an infringement of National and International Copyright Law. A Colorado Statutory Declaration (Board Rule 6.2.2) Certificate herein: I have been performing as the professional land surveyor or under the professional land surveyor in responsible charge (I) are based upon the professional land surveyor's knowledge, information and belief (I) are in accordance with applicable standards of practice (I) are not a quantity or warranty, either expressed or implied.